


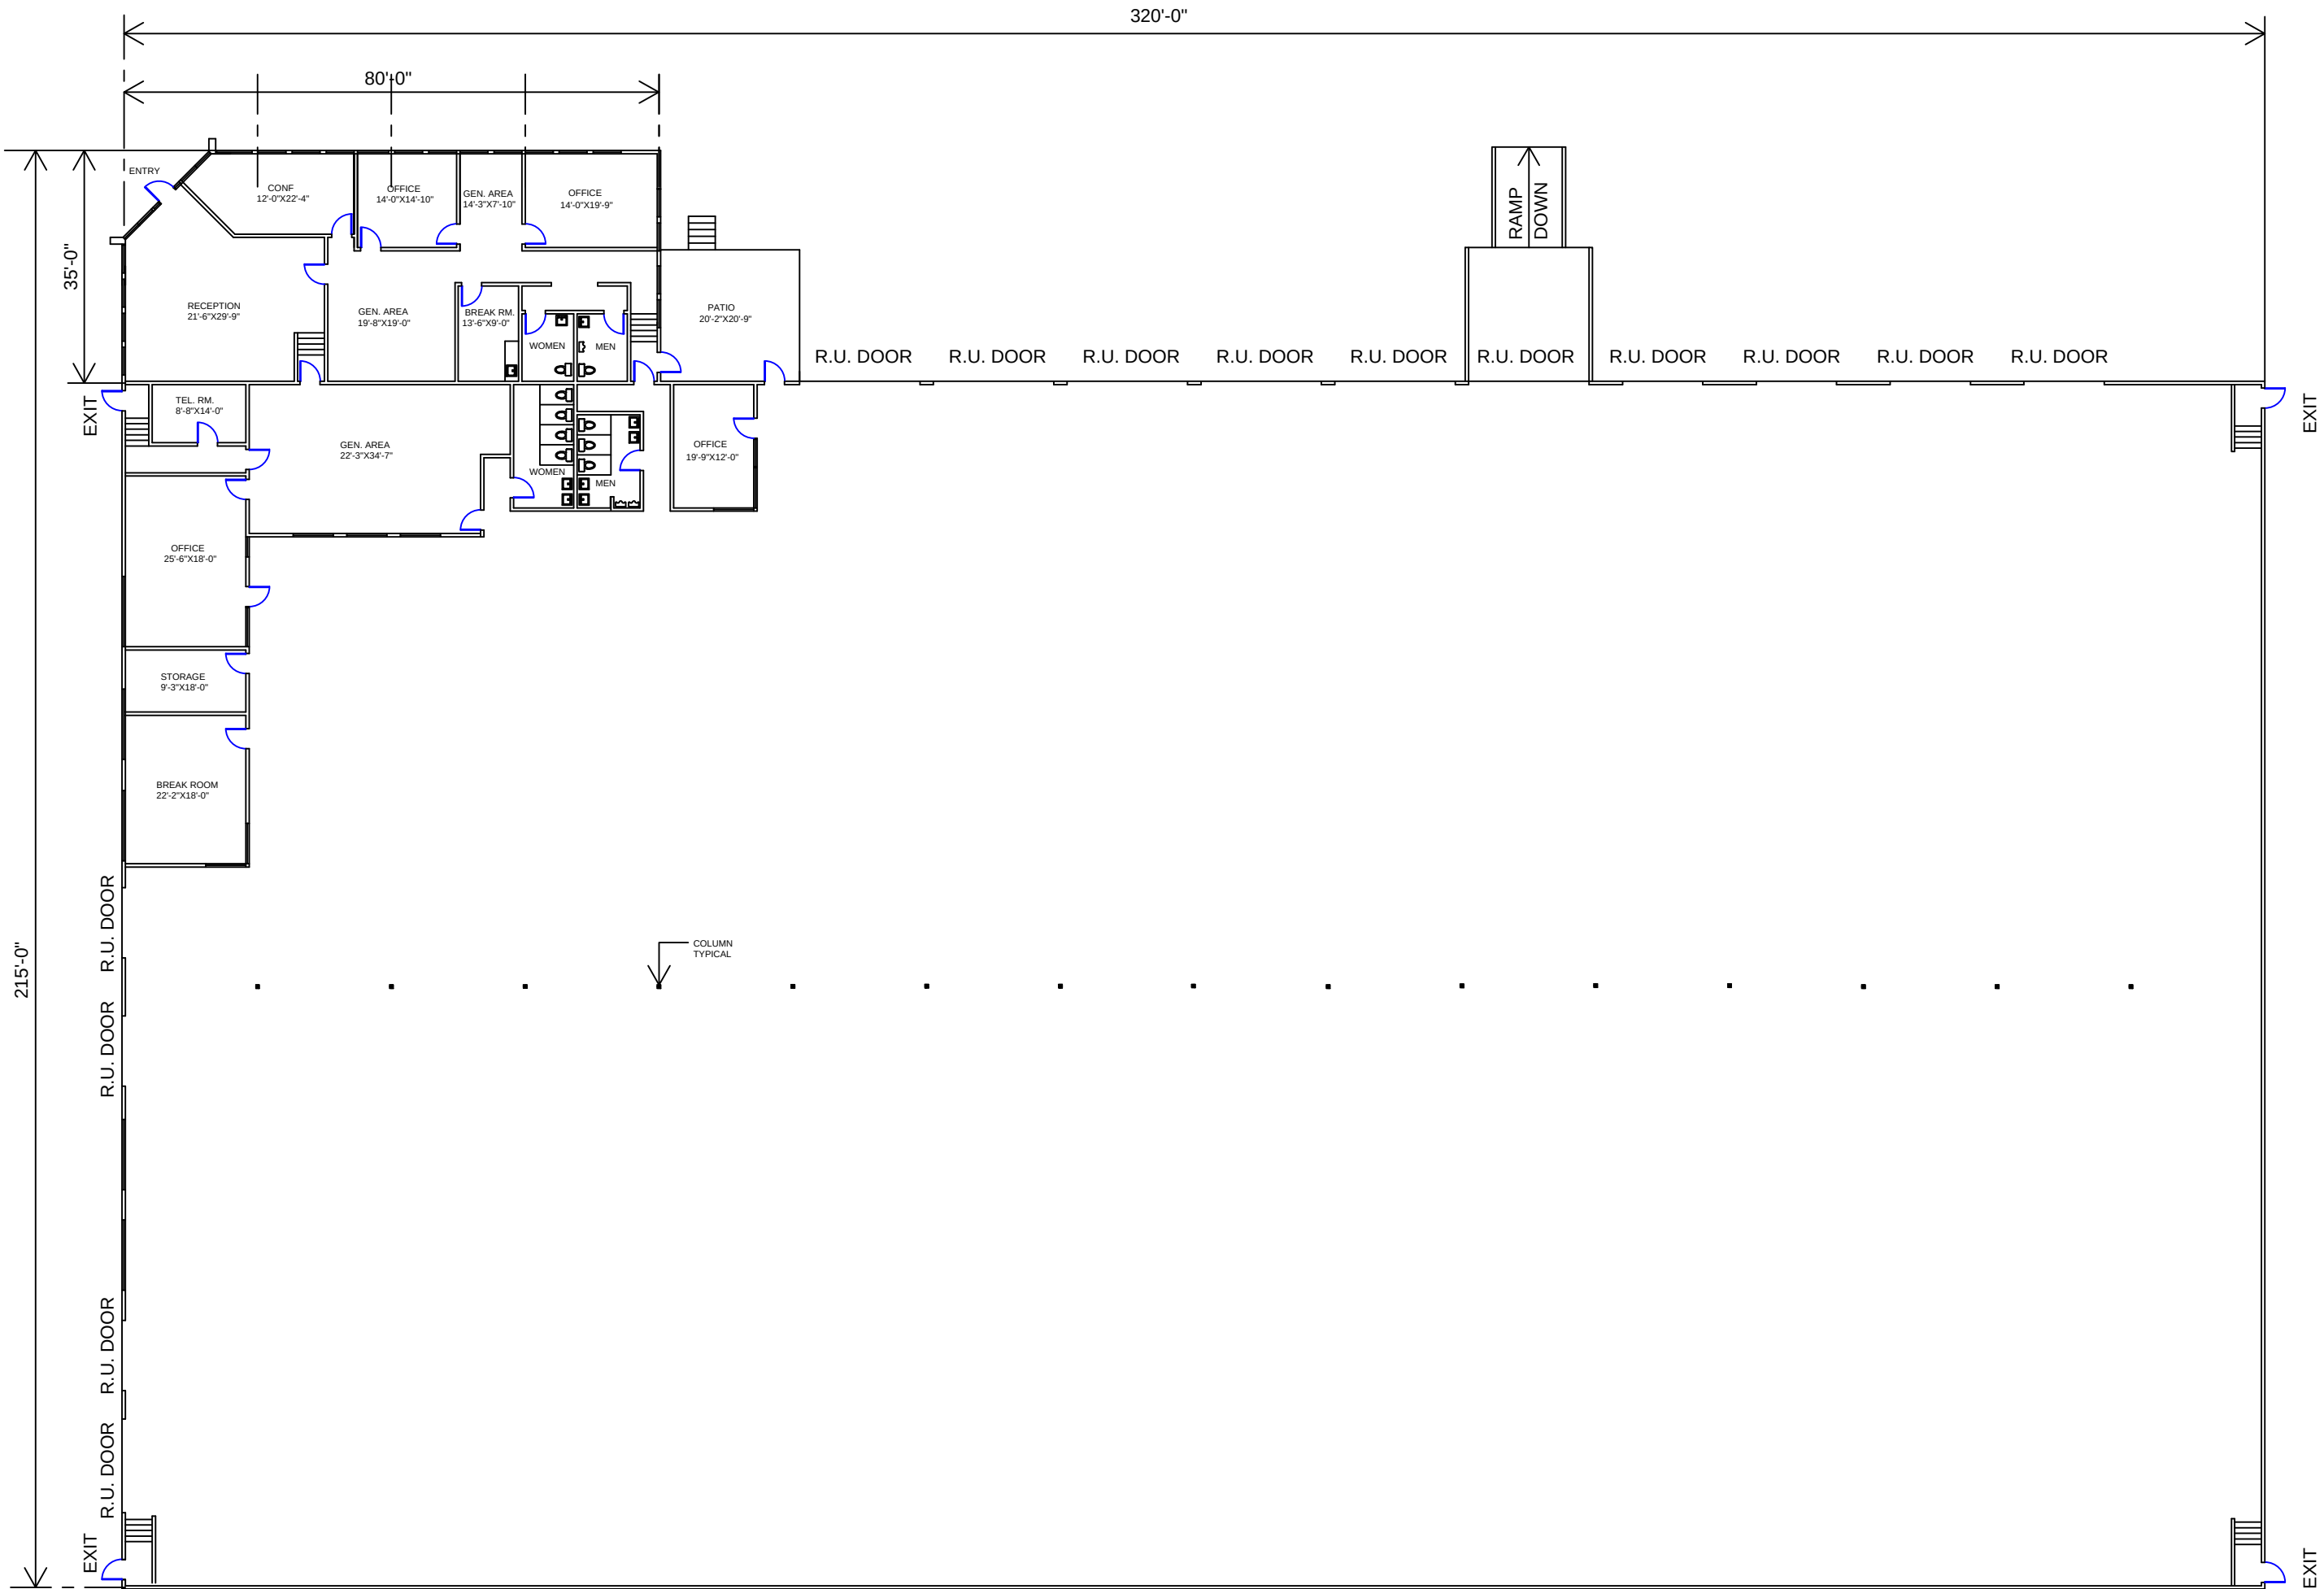

Issues & Revisions	
	△
	△
Architectural Design Services
COMMERCIAL SPACE PLANNING AND DESIGN

7 Via Amistosa, suite 1
rancho santa margarita, california 92688
telephone: 949.412.4124

12900 SIMMS AVENUE
LOS ANGELES, CALIFORNIA

AS BUILT

Scale:	1/16"=1'-0"
page	of sheets
DATE:	11-18-11
Sheet #:	

AB