







POWER PLAN SYMBOLS LEGEND:
● DUPLEX WALL OUTLET
● DUPLEX FLOOR OUTLET
● TELEPHONE WALL OUTLET
● TELEPHONE FLOOR OUTLET

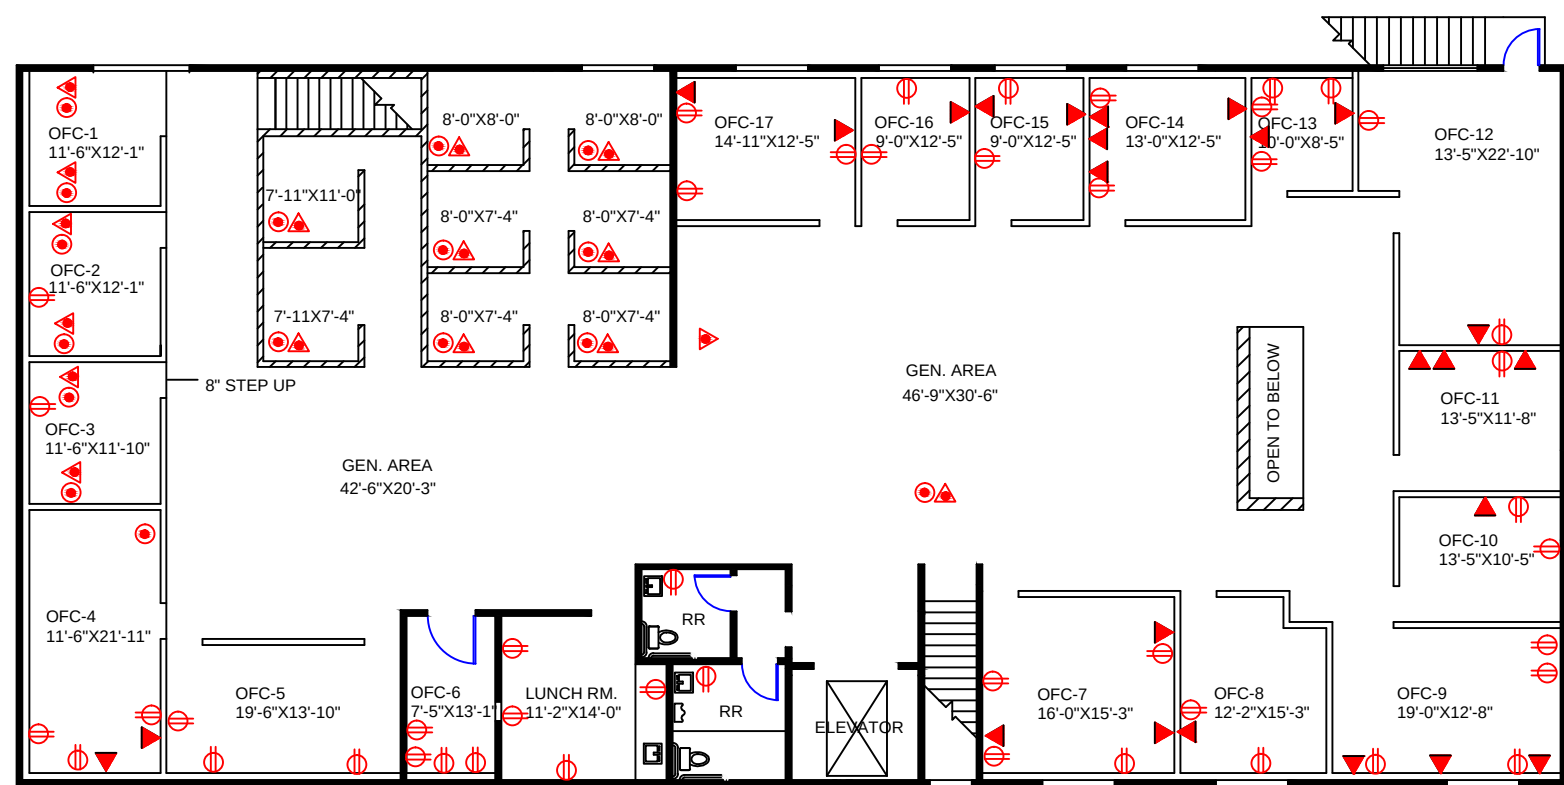

AS BUILT PLAN FOR:
MEZZANINE POWER PLAN
1933 WEST 60TH STREET
LOS ANGELES, CALIFORNIA 90047

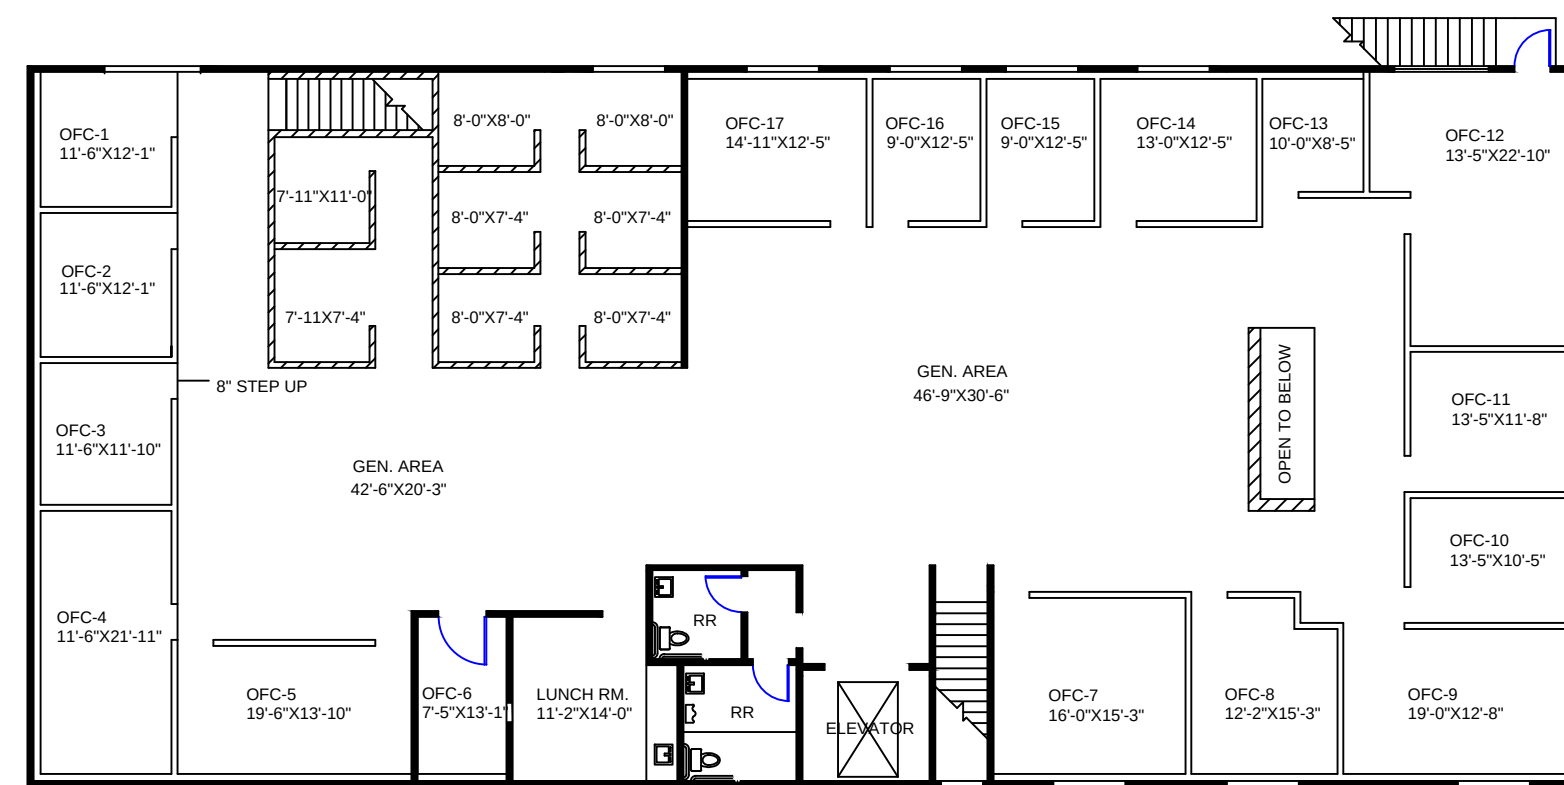

AS BUILT PLAN FOR:
MEZZANINE AS BUILT
1933 WEST 60TH STREET
LOS ANGELES, CALIFORNIA 90047

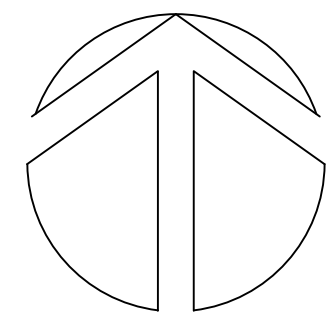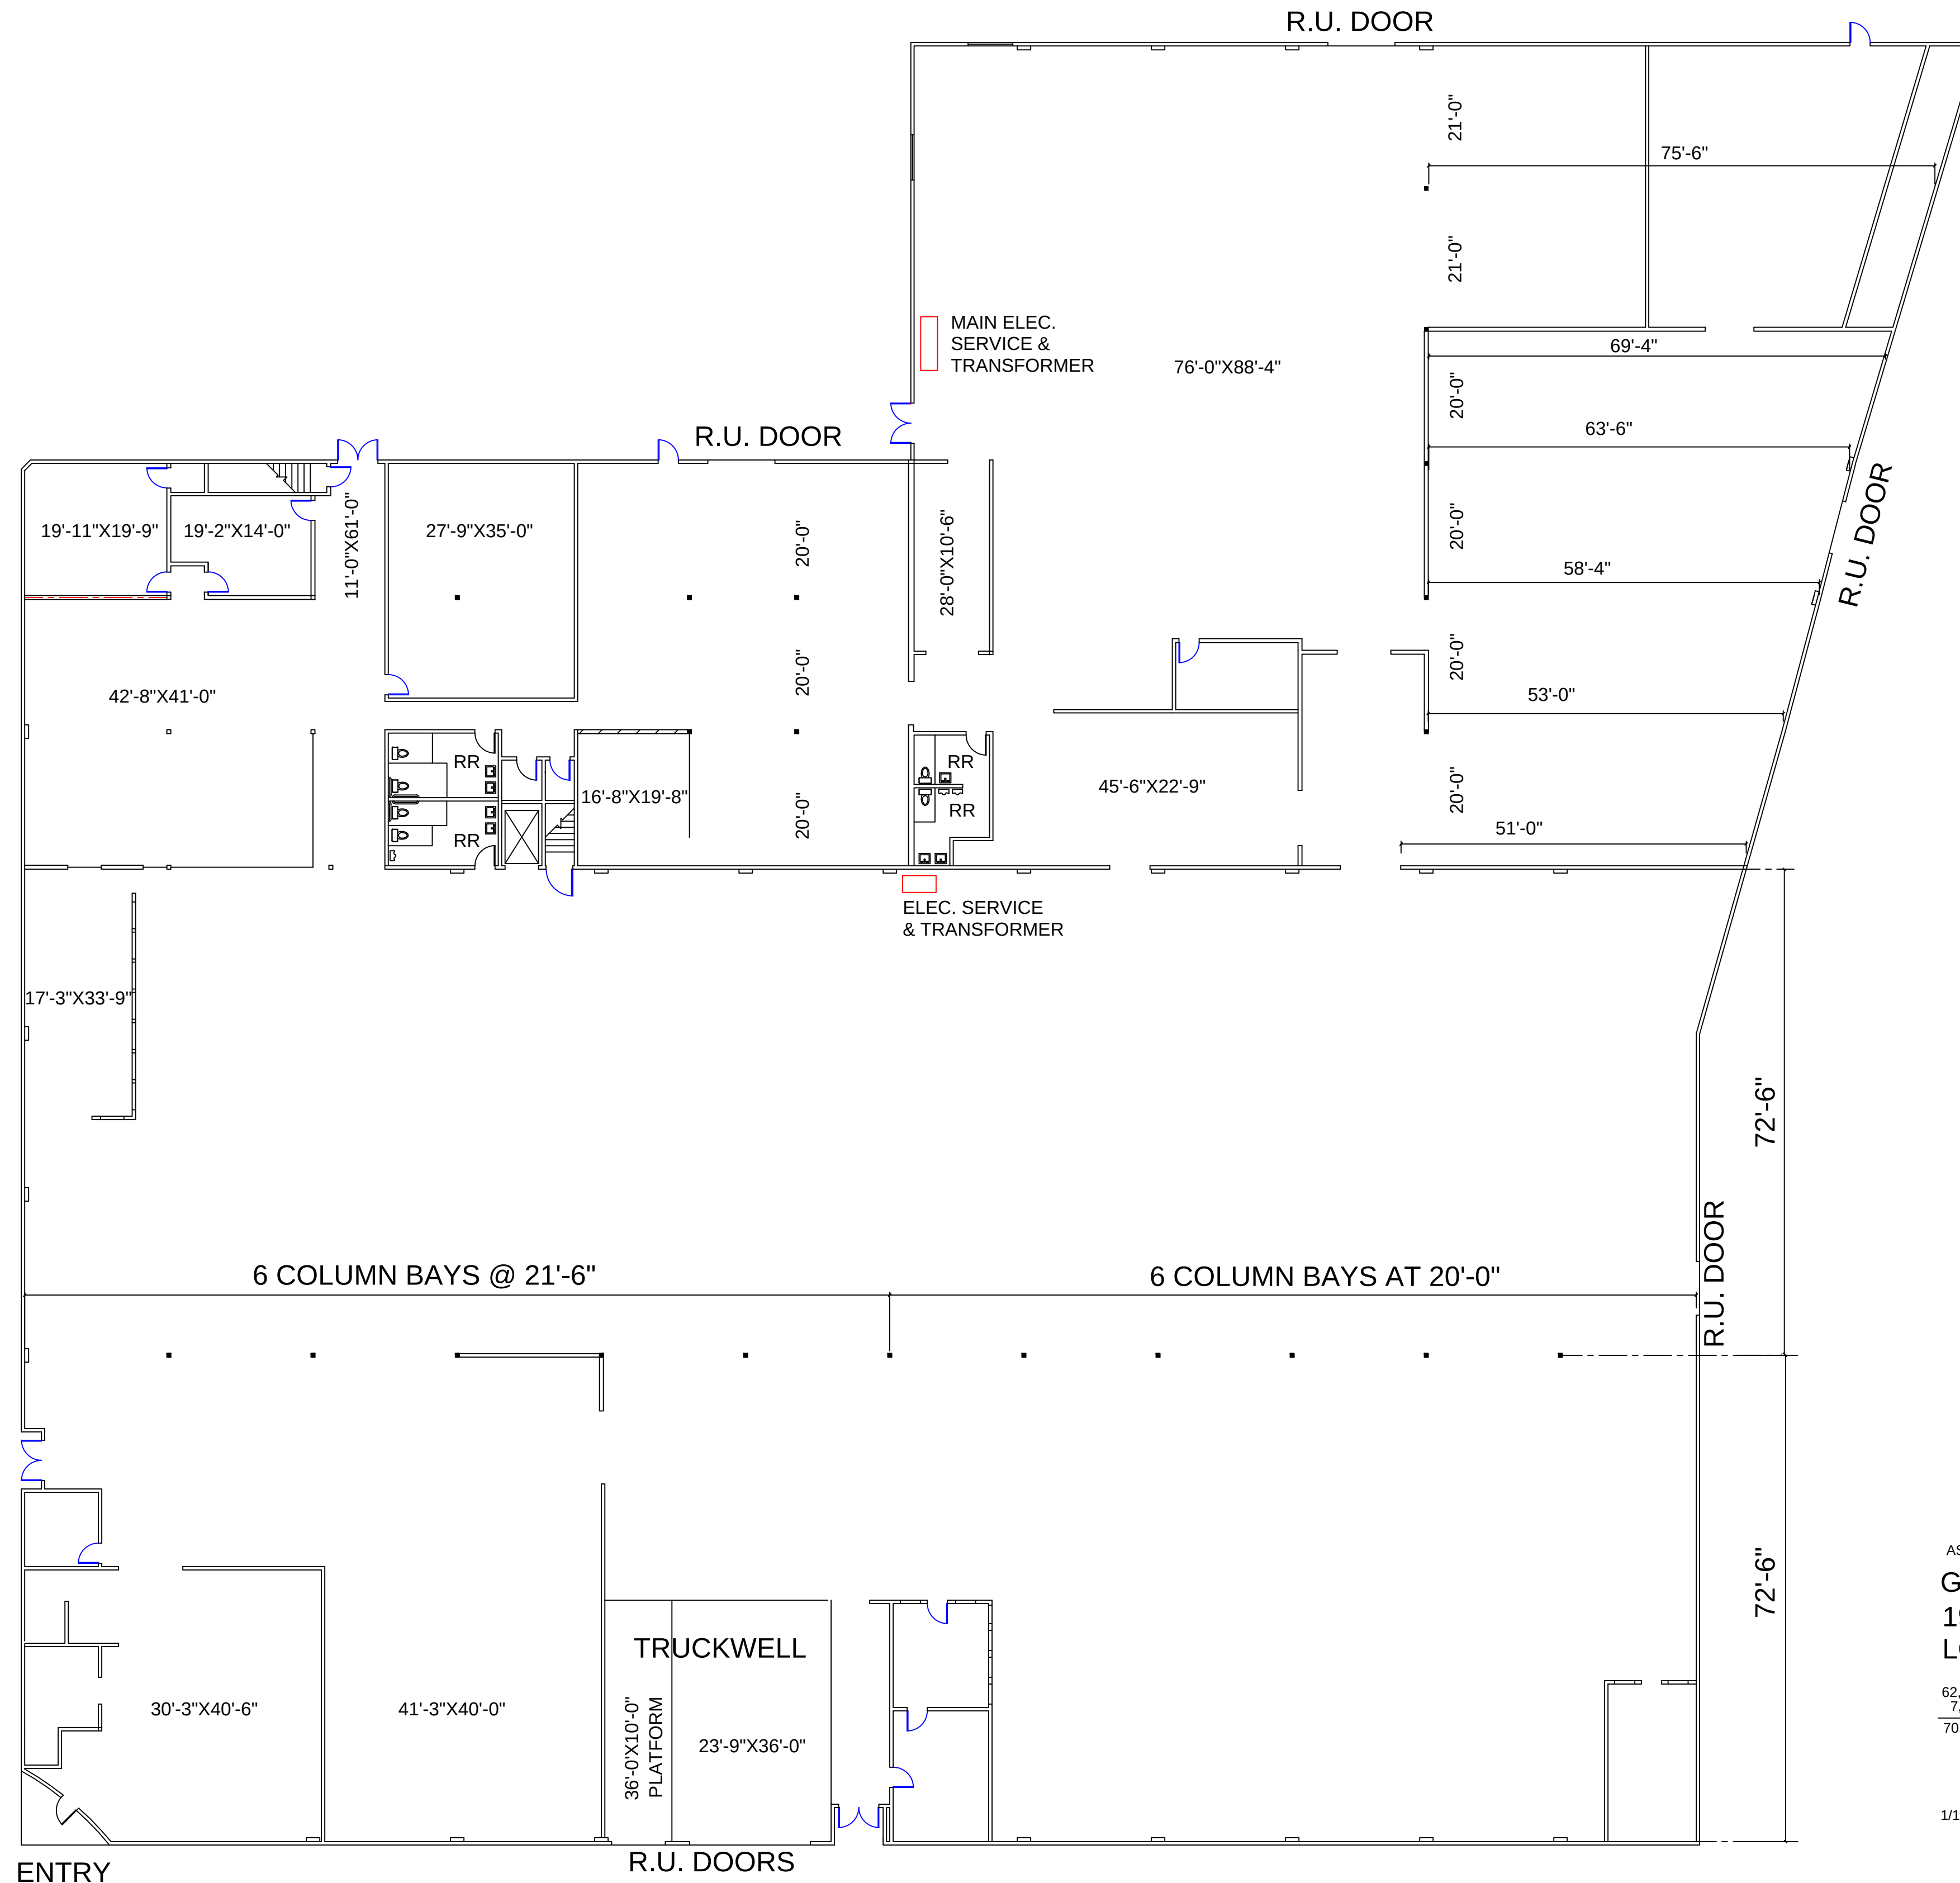

NORTH

AS BUILT PLAN FOR:
GROUND FLOOR WAREHOUSE
1933 WEST 60TH STREET
LOS ANGELES, CALIFORNIA 90047

62,531 GROSS AREA SQUARE FEET (GROUND FLOOR)
7,780 GROSS AREA SQUARE FEET (MEZZANINE)
70,311 GROSS AREA SQUARE FEET (TOTAL)

1/16"=1'-0"