


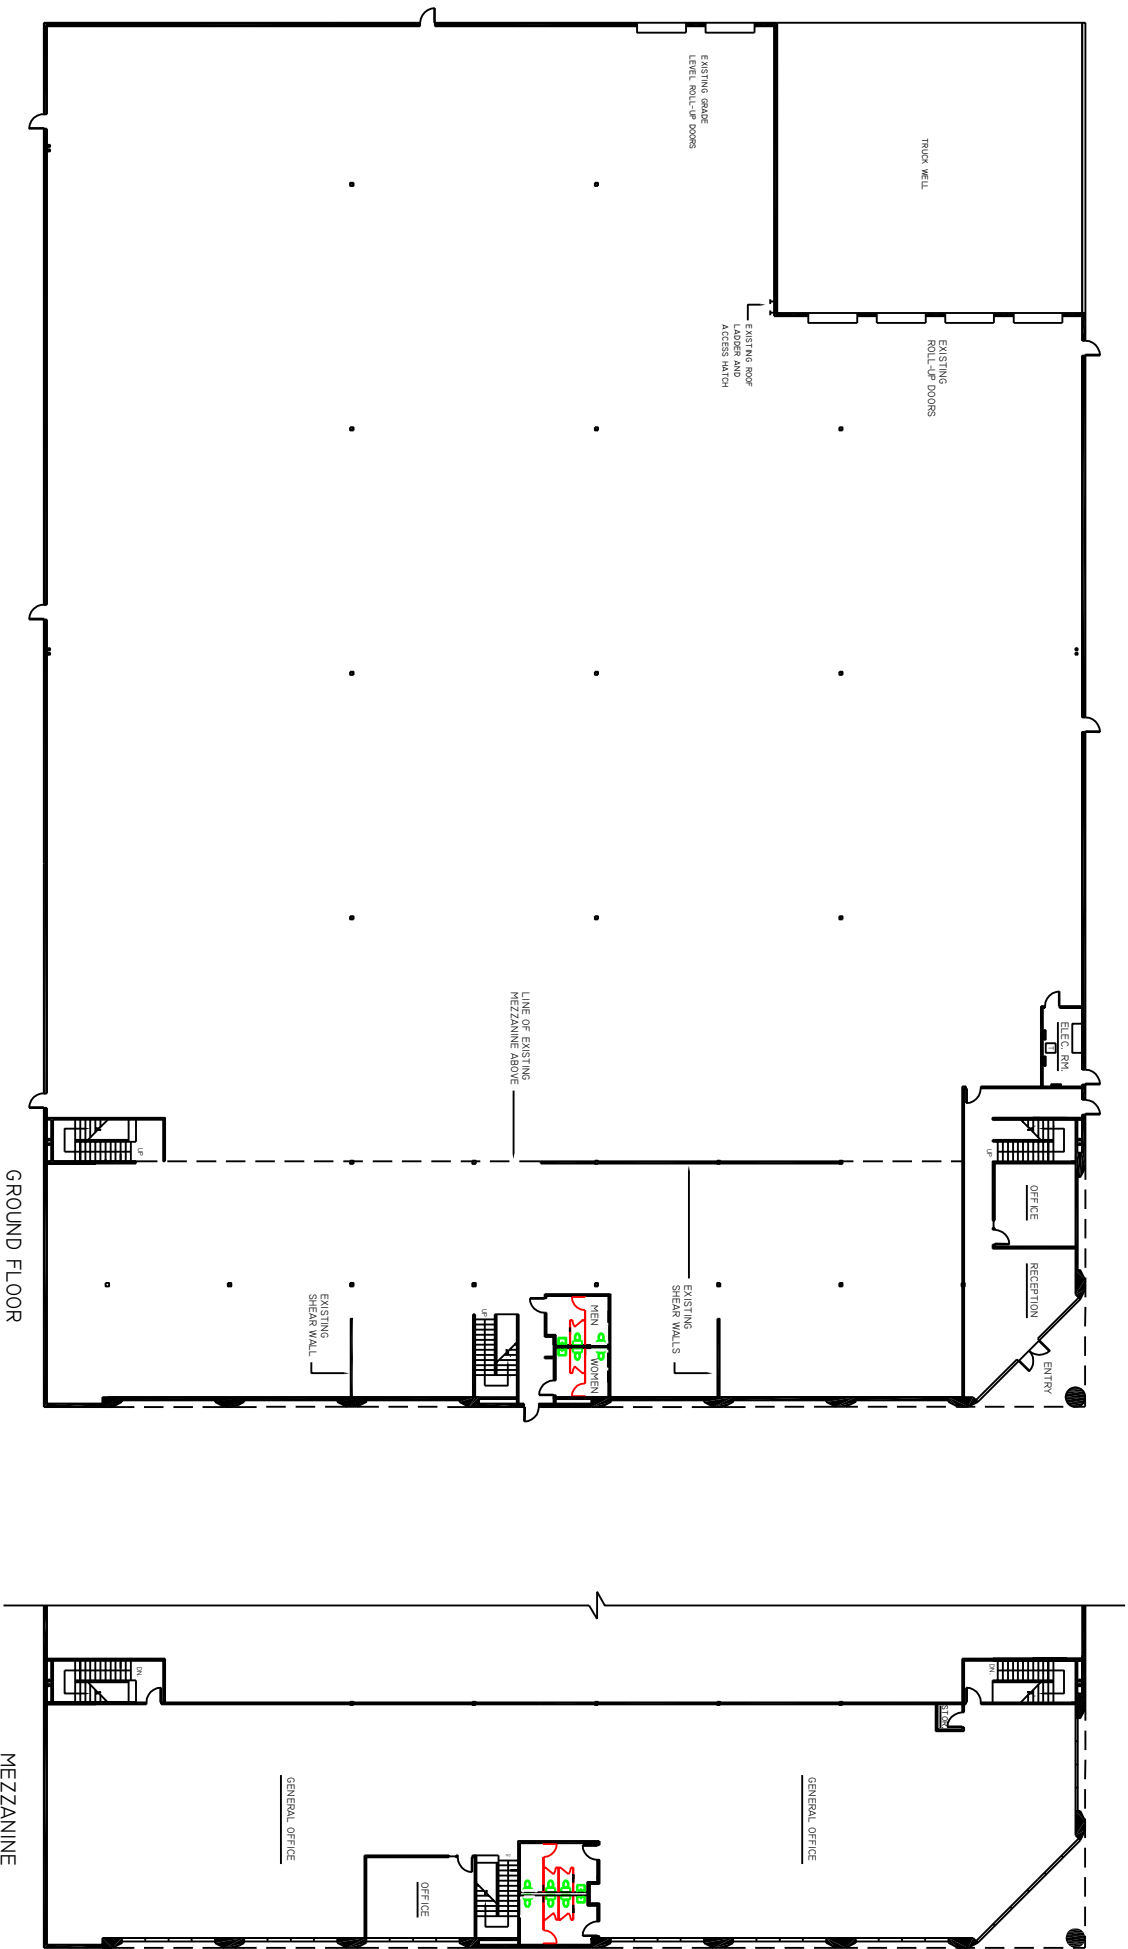

REEF CYPRESS CORPORATE PARK - BUILDING 4 FLOOR PLAN

10741 WALKER STREET, CYPRESS, CALIFORNIA

1/16"=1'-0"